



COPYRIGHT
 This design and information is the sole copyright of The A.D.M. partnership and reproduction in any form is forbidden unless express permission is obtained in writing.
 Do not scale off dimensions from this drawing. All dimensions are to be checked on site and any discrepancies reported to ADM partnership in writing.
 This drawing must be read in conjunction with any related A.D.M. drawings, specification / bill of quantities together with all other consultants information including structural, mechanical and electrical information.
 Contractors, sub-contractors and suppliers must verify all dimensions on site before commencing any work or producing any shop drawings.
 Work and materials to be in accordance with the Building Regulations and to comply with all relevant British Standards.

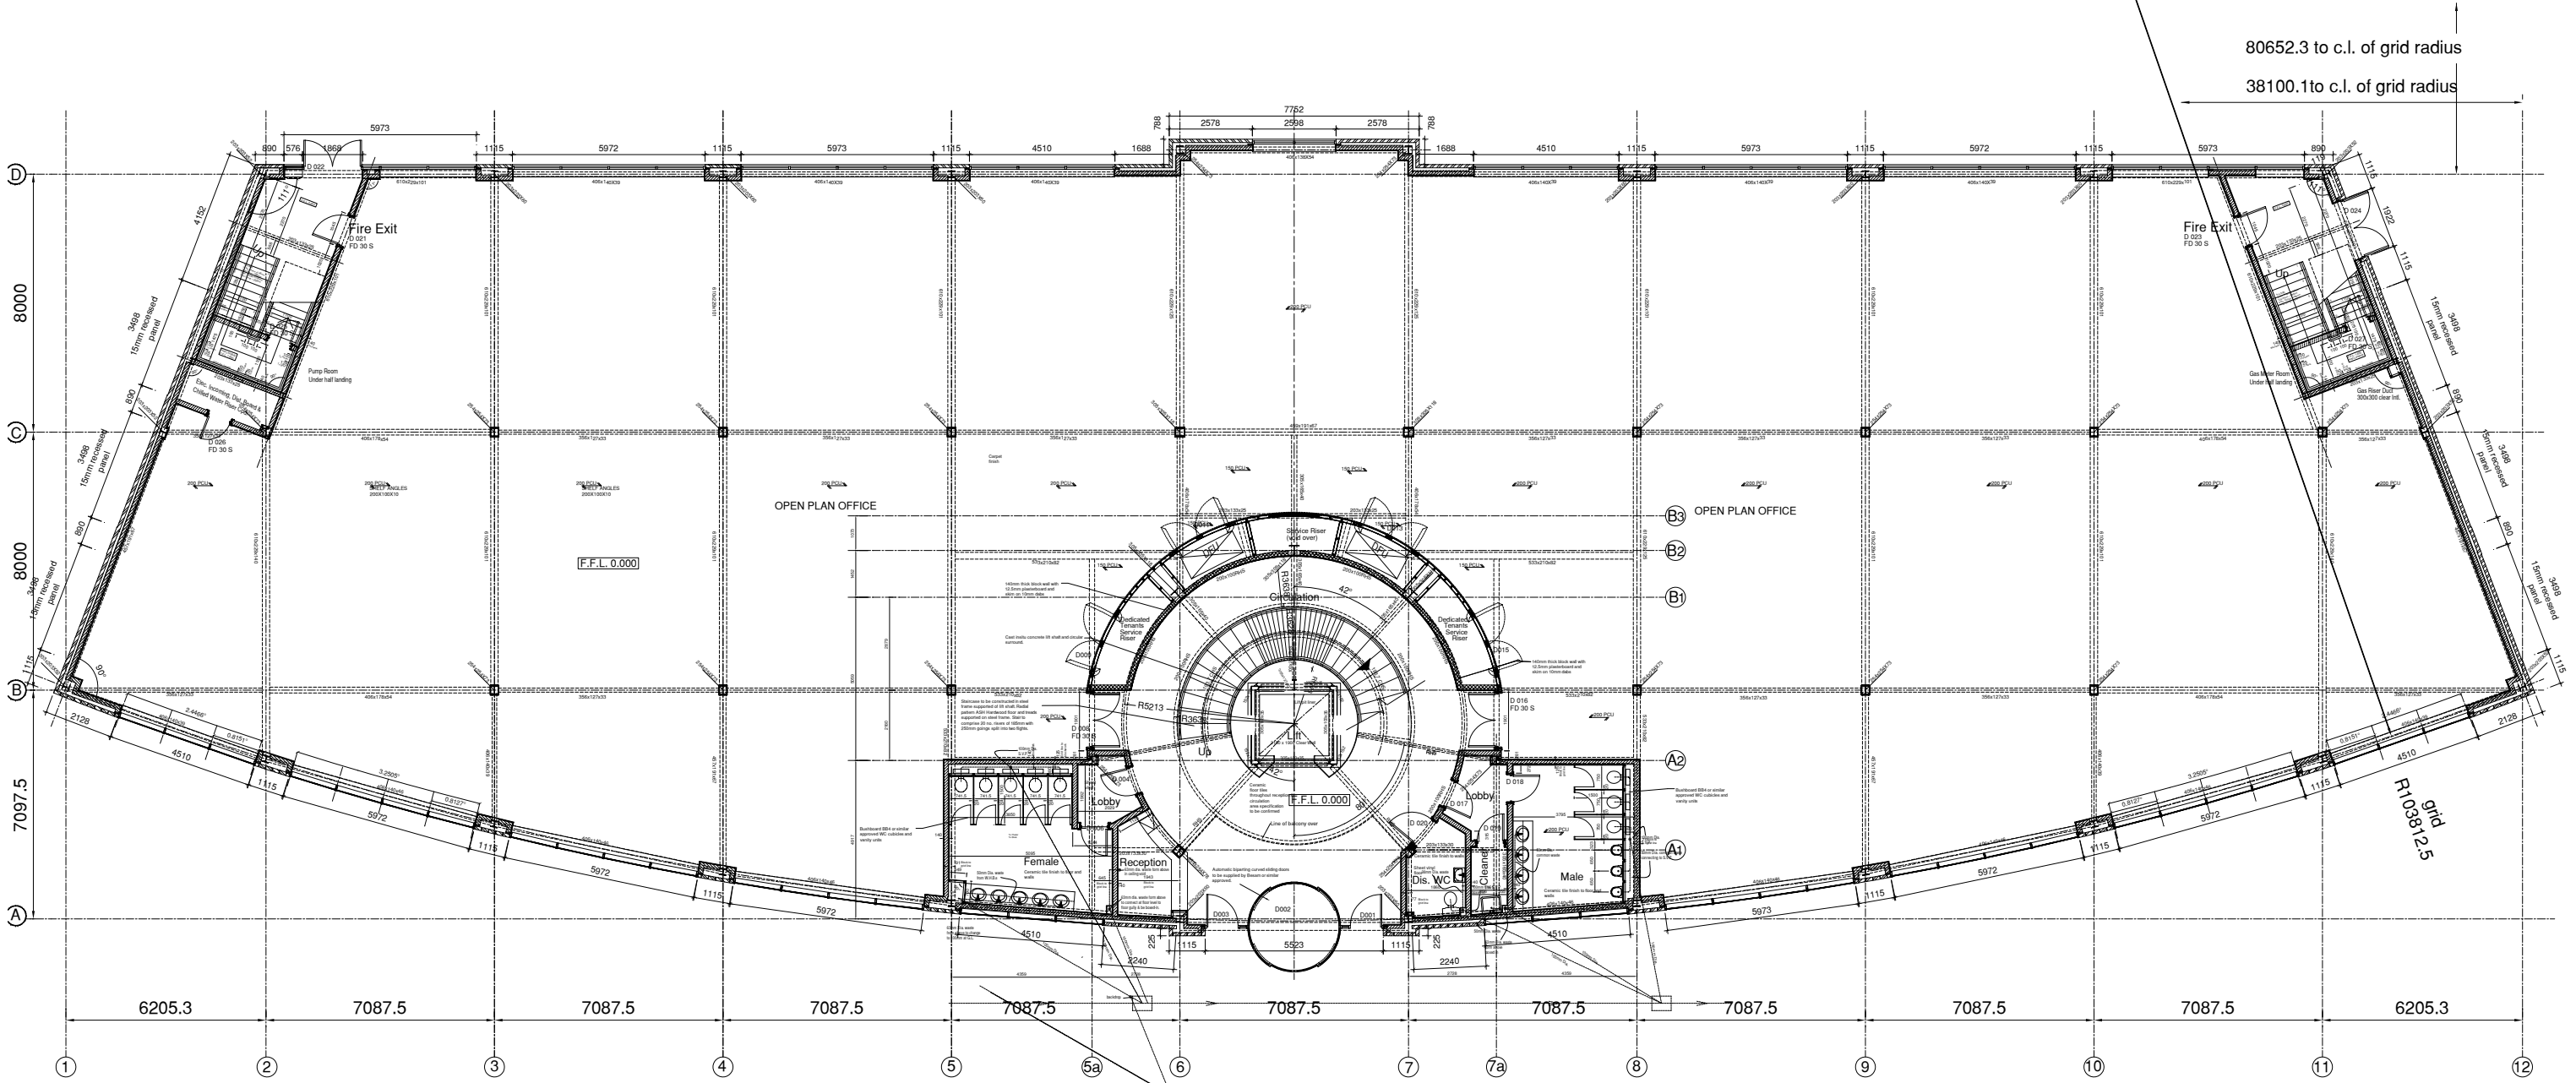

GROUND FLOOR

Q1

<div style="border: 1px solid black; padding: 5px; display: inline-block;">AS-BUILT 29-07-02</div>		Drawing Title		GROUND FLOOR PLAN	
		Scale	1:100	Date	18.07.01
B	02-11-01	Brickwork dims between grids 6 & 7 revised DFU Walls and doors revised	MF	Drawn By	AS/GSE
A	16.08.01	DFU's revised. Doors D006 & D020 handed Pump room and Gas Meter rooms added Elec. & Chilled Water Riser Cub.d added	LC	Checked	-
Rev	Date	Revisions	By	Drawing No.	850-205
				Rev.	B



The A.D.M. partnership
 HEAD OFFICE:
 7, Ashley Business Ct.
 Rawmarsh Road,
 Rotherham S60 1RU
 Tel : 01709 367068
 Fax : 01709 720808

Client	GRANTSIDE DEVELOPMENTS LTD
Job Title	QUORUM 1 BALLIOL BUSINESS PARK EAST LONGBENTON NEWCASTLE UPON TYNE